


CHIEF SYSAU PROJECTOR CEILING MOUNT - DETAIL VIEWS

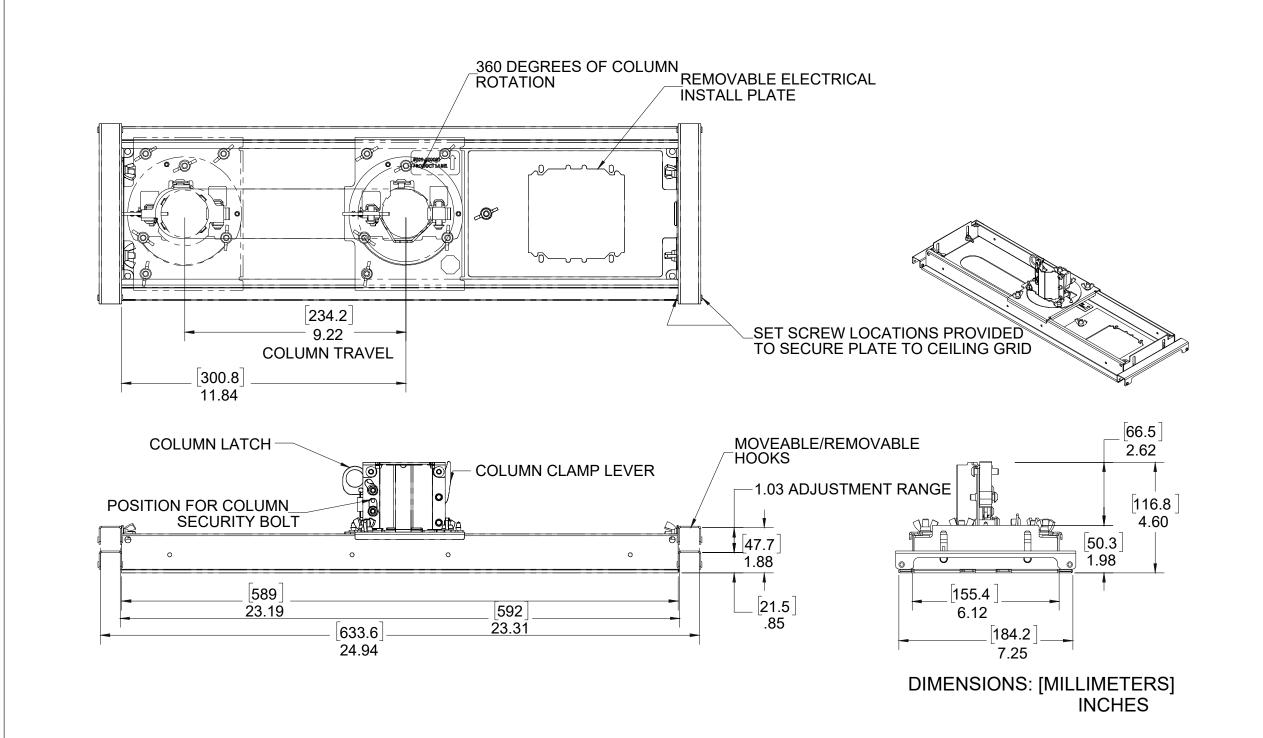

02 CHIEF SYSAU PROJECTOR CEILING MOUNT - DETAIL VIEWS

SHEET 4 - UNIVERSAL INTERFACE

Scale: 3" = 1'-0"

- MICRO/MACRO ADJUST KNOB ROLL MICRO ADJUST KNOB ± 3° ROLL ADJUSTMENT PITCH MICRO ADJUST KNOB ±10° PITCH ADJUSTMENT ±10° YAW ADJUSTMENT - ADJUSTMENT SET SCREW ([173.1] 6.82 MICRO/MACRO ADJUST KNOB YAW MICRO/MACRO ADJUST KNOB ROLL ADJUSTMENT SET SCREW YAW MICRO __ ADJUST KNOB $^{\prime}$ YAW ADJUSTMENT SET SCREW DIMENSIONAL VIEWS OFMOUNT SHOWN WITHOUT COLUMN AND COVER TO INCREASE CLARITY

CHIEF SYSAU PROJECTOR CEILING MOUNT - DETAIL VIEWS

ADJUSTABLE FEET

NOTE:
13.937
13.91

NOTE:
1.500 FRACE SHOWN ASSEMBLED. SHIPPED AS LOOSE PIECES
1.7 FOUR LEGS SHOWN A MINIMUM OF THREE LEGS MUST BE USED

TO PROPERLY MOUNT THE PROJECTOR

A CHIEF SYSAU PROJECTOR CEILING MOUNT - DETAIL VIEWS

GENERAL NOTES

- A. ROOM LAYOUTS ARE TYPICAL AND ARE FOR REFERENCE ONLY. REFER TO ARCHITECTURAL PLANS FOR EXACT ROOM LAYOUTS
- B. ALL POWER TO BE PROVIDED BY OTHERS.
- C. ALL DATA TO BE POE+ AND PROVIDED BY OTHERS
- D. THE AV SYSTEM SHOULD RECEIVE A SINGLE PHASE FEED THAT IS PROPERLY GROUNDED.
- E. SSW-102 AVAILABILITY SIGN INSTALLED IN LOCATIONS FACING OPEN BULL PENS AND PARTITIONED CUBICLE AREAS.
- F. TSW-760-LB LIGHT BAR INSTALLED IN HALLWAYS AND CORRIDORS.

○ SHEET KEYNOTES

 CHIEF SYSAU SUSPENDED CEILING PROJECTOR SYSTEM. LEVEL3
AUDIO VISUAL

955 E. Javelina Avenue Mesa, Arizona 85204 T: 480.892.1071 F: 480.892.5295 www.L3AV.com



CLIENT:

BUILDING 37 MODERNIZATION

PROJECT NAME:

8000 S FEDERAL WAY BOISE ID 83716-9632

SITE ADDRESS:

NO.:	DATE	DESCRIPTION
0	09/08/2021	FOR REVIEW
1	09/17/2021	FOR CONSTRUCTION
2	09/27/2021	REVISION 1
3	07/08/2022	ZRX119 & TR2D ADD
4	08/02/2022	REDLINE CORRECTIONS
5	09/16/2022	AS-BUILTS

ISSUED FOR:

PROJECT NO.: 5509

SCALE:

3"=1'

DRAWN BY: M. HOMEWOOD

APPROVED BY:

BUILDING:

FLOOR:

ROOM:

MOUNTING
DETAILS - SYSAU
PROJECTOR
MOUNT

SHEET TITLE

TA506

SHEET NUMBER:

/ Scale: 3" = 1'-0"

SHEET 3 - PROJECTOR MOUNT AND COLUMN

SHEET 1 - OVERVIEW

A PLOT DATE: 9/19/2022 12:40 PM

©2018 LEVEL 3 AUDIO VISUAL